



Chipsmall Limited consists of a professional team with an average of over 10 year of expertise in the distribution of electronic components. Based in Hongkong, we have already established firm and mutual-benefit business relationships with customers from,Europe,America and south Asia,supplying obsolete and hard-to-find components to meet their specific needs.

With the principle of “Quality Parts,Customers Priority,Honest Operation,and Considerate Service”,our business mainly focus on the distribution of electronic components. Line cards we deal with include Microchip,ALPS,ROHM,Xilinx,Pulse,ON,Everlight and Freescale. Main products comprise IC,Modules,Potentiometer,IC Socket,Relay,Connector.Our parts cover such applications as commercial,industrial, and automotives areas.

We are looking forward to setting up business relationship with you and hope to provide you with the best service and solution. Let us make a better world for our industry!




## Contact us

Tel: +86-755-8981 8866 Fax: +86-755-8427 6832


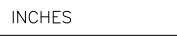
Email & Skype: [info@chipsmall.com](mailto:info@chipsmall.com) Web: [www.chipsmall.com](http://www.chipsmall.com)

Address: A1208, Overseas Decoration Building, #122 Zhenhua RD., Futian, Shenzhen, China



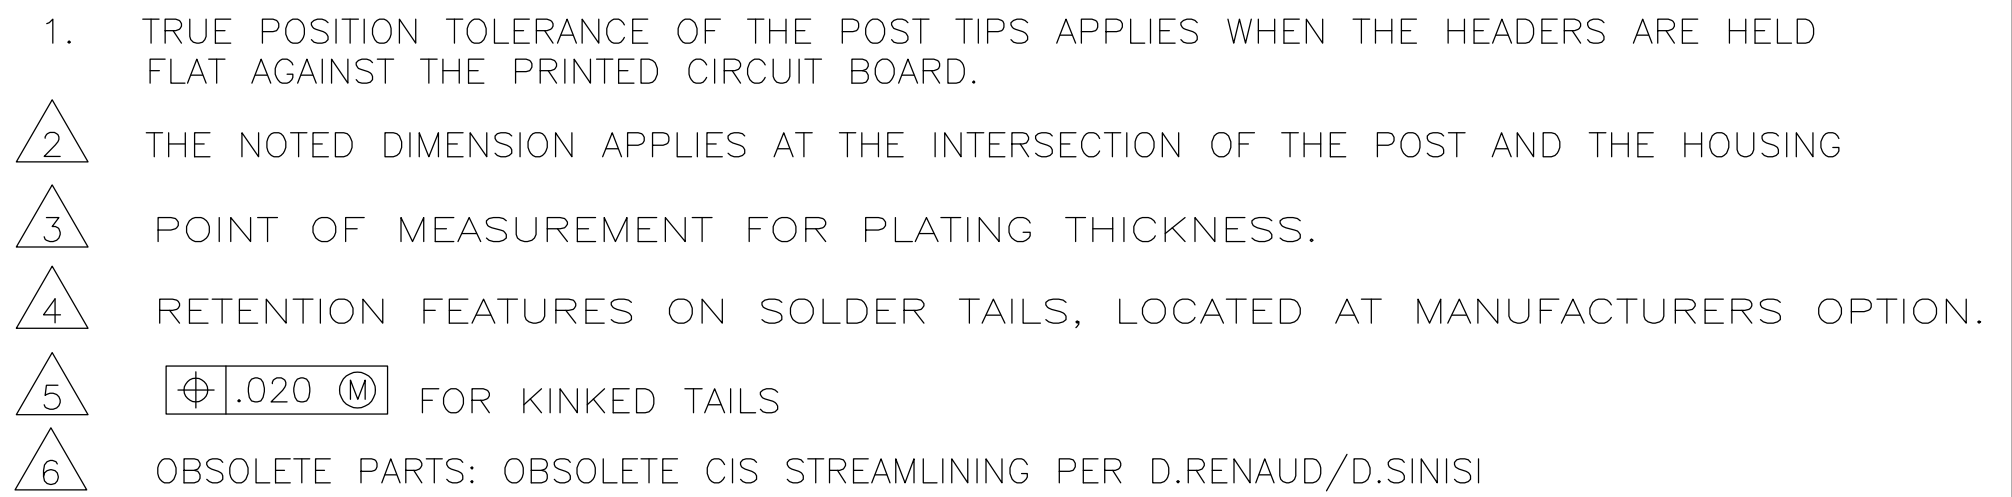

<div><div>6</div><div>SUP BY 7-146289-4</div></div>	<div><div>6</div><div>OBSOLETE</div></div>	3.984	3.900	39	40	2-104426-7
		3.484	3.400	34	35	<del>2-104426-6</del>
		2.984	2.900	29	30	<del>2-104426-5</del>
		2.584	2.500	25	26	<del>2-104426-4</del>
		2.484	2.400	24	25	<del>2-104426-3</del>
	2.384	2.300	23	24	<del>2-104426-2</del>	
	<div><div>6</div><div>OBSOLETE</div></div>	2.284	2.200	22	23	<del>2-104426-1</del>
		2.184	2.100	21	22	<del>2-104426-0</del>
		2.084	2.000	20	21	<del>1-104426-9</del>
		1.984	1.900	19	20	<del>1-104426-8</del>
		1.884	1.800	18	19	<del>1-104426-7</del>
		1.784	1.700	17	18	<del>1-104426-6</del>
		1.684	1.600	16	17	<del>1-104426-5</del>
		1.584	1.500	15	16	<del>1-104426-4</del>
		1.484	1.400	14	15	<del>1-104426-3</del>
		1.384	1.300	13	14	<del>1-104426-2</del>
		1.284	1.200	12	13	<del>1-104426-1</del>
	1.184	1.100	11	12	<del>1-104426-0</del>	
	1.084	1.000	10	11	<del>1-104426-9</del>	
	<div><div>6</div><div>OBSOLETE</div></div>	.984	.900	9	10	104426-8
.884		.800	8	9	<del>104426-7</del>	
.784		.700	7	8	<del>104426-6</del>	
.684		.600	6	7	<del>104426-5</del>	
.584		.500	5	6	104426-4	
.484		.400	4	5	104426-3	
.384		.300	3	4	104426-2	
.284		.200	2	3	104426-1	
	C	B	A	NO OF POSN	ASSEMBLY PART NUMBER	

THIS DRAWING IS A CONTROLLED DOCUMENT.		DWN H. MOLL 28JUN88		 TE Connectivity	
		CHK R. FEIDT 28JUN88			
DIMENSIONS: INCHES		TOLERANCES, UNLESS OTHERWISE SPECIFIED:		NAME	
		APVD R. FEIDT 28JUN88			
0 PLC ± — 1 PLC ± — 2 PLC ± — 3 PLC ± .005 4 PLC ± — ANGLES ± —		PRODUCT SPEC —		HEADER ASSY, MOD II, BREAKAWAY, SINGLE ROW, .100 CL VERT, 025 SQ POSTS, WITH RETENTION FEATURE	
MATERIAL		APPLICATION SPEC —			
HOUSING: FLAME RETARDANT THERMOPLASTIC COLOR—BLACK POSTS: RHOSPOR BRONZE		FINISH POSTS: .000030 GOLD IN CONTACT AREA, .000100— .000200 MATTE TIN—LEAD ON SOLDER TAIL ALL OVER .000050 NICKEL		SIZE A2	
		WEIGHT —		CAGE CODE 00779	
		CUSTOMER DRAWING		DRAWING NO C-104426	
				RESTRICTED TO —	
				SCALE 4:1	
				SHEET 1 of 1	
				REV 12	